




Record Set

Turner Construction
 Clearwater Library Project
 PCO #011 27 Sept 02
 Revision (4)

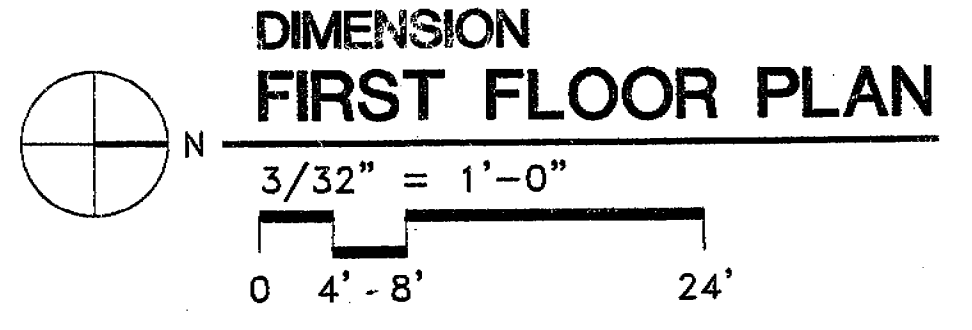

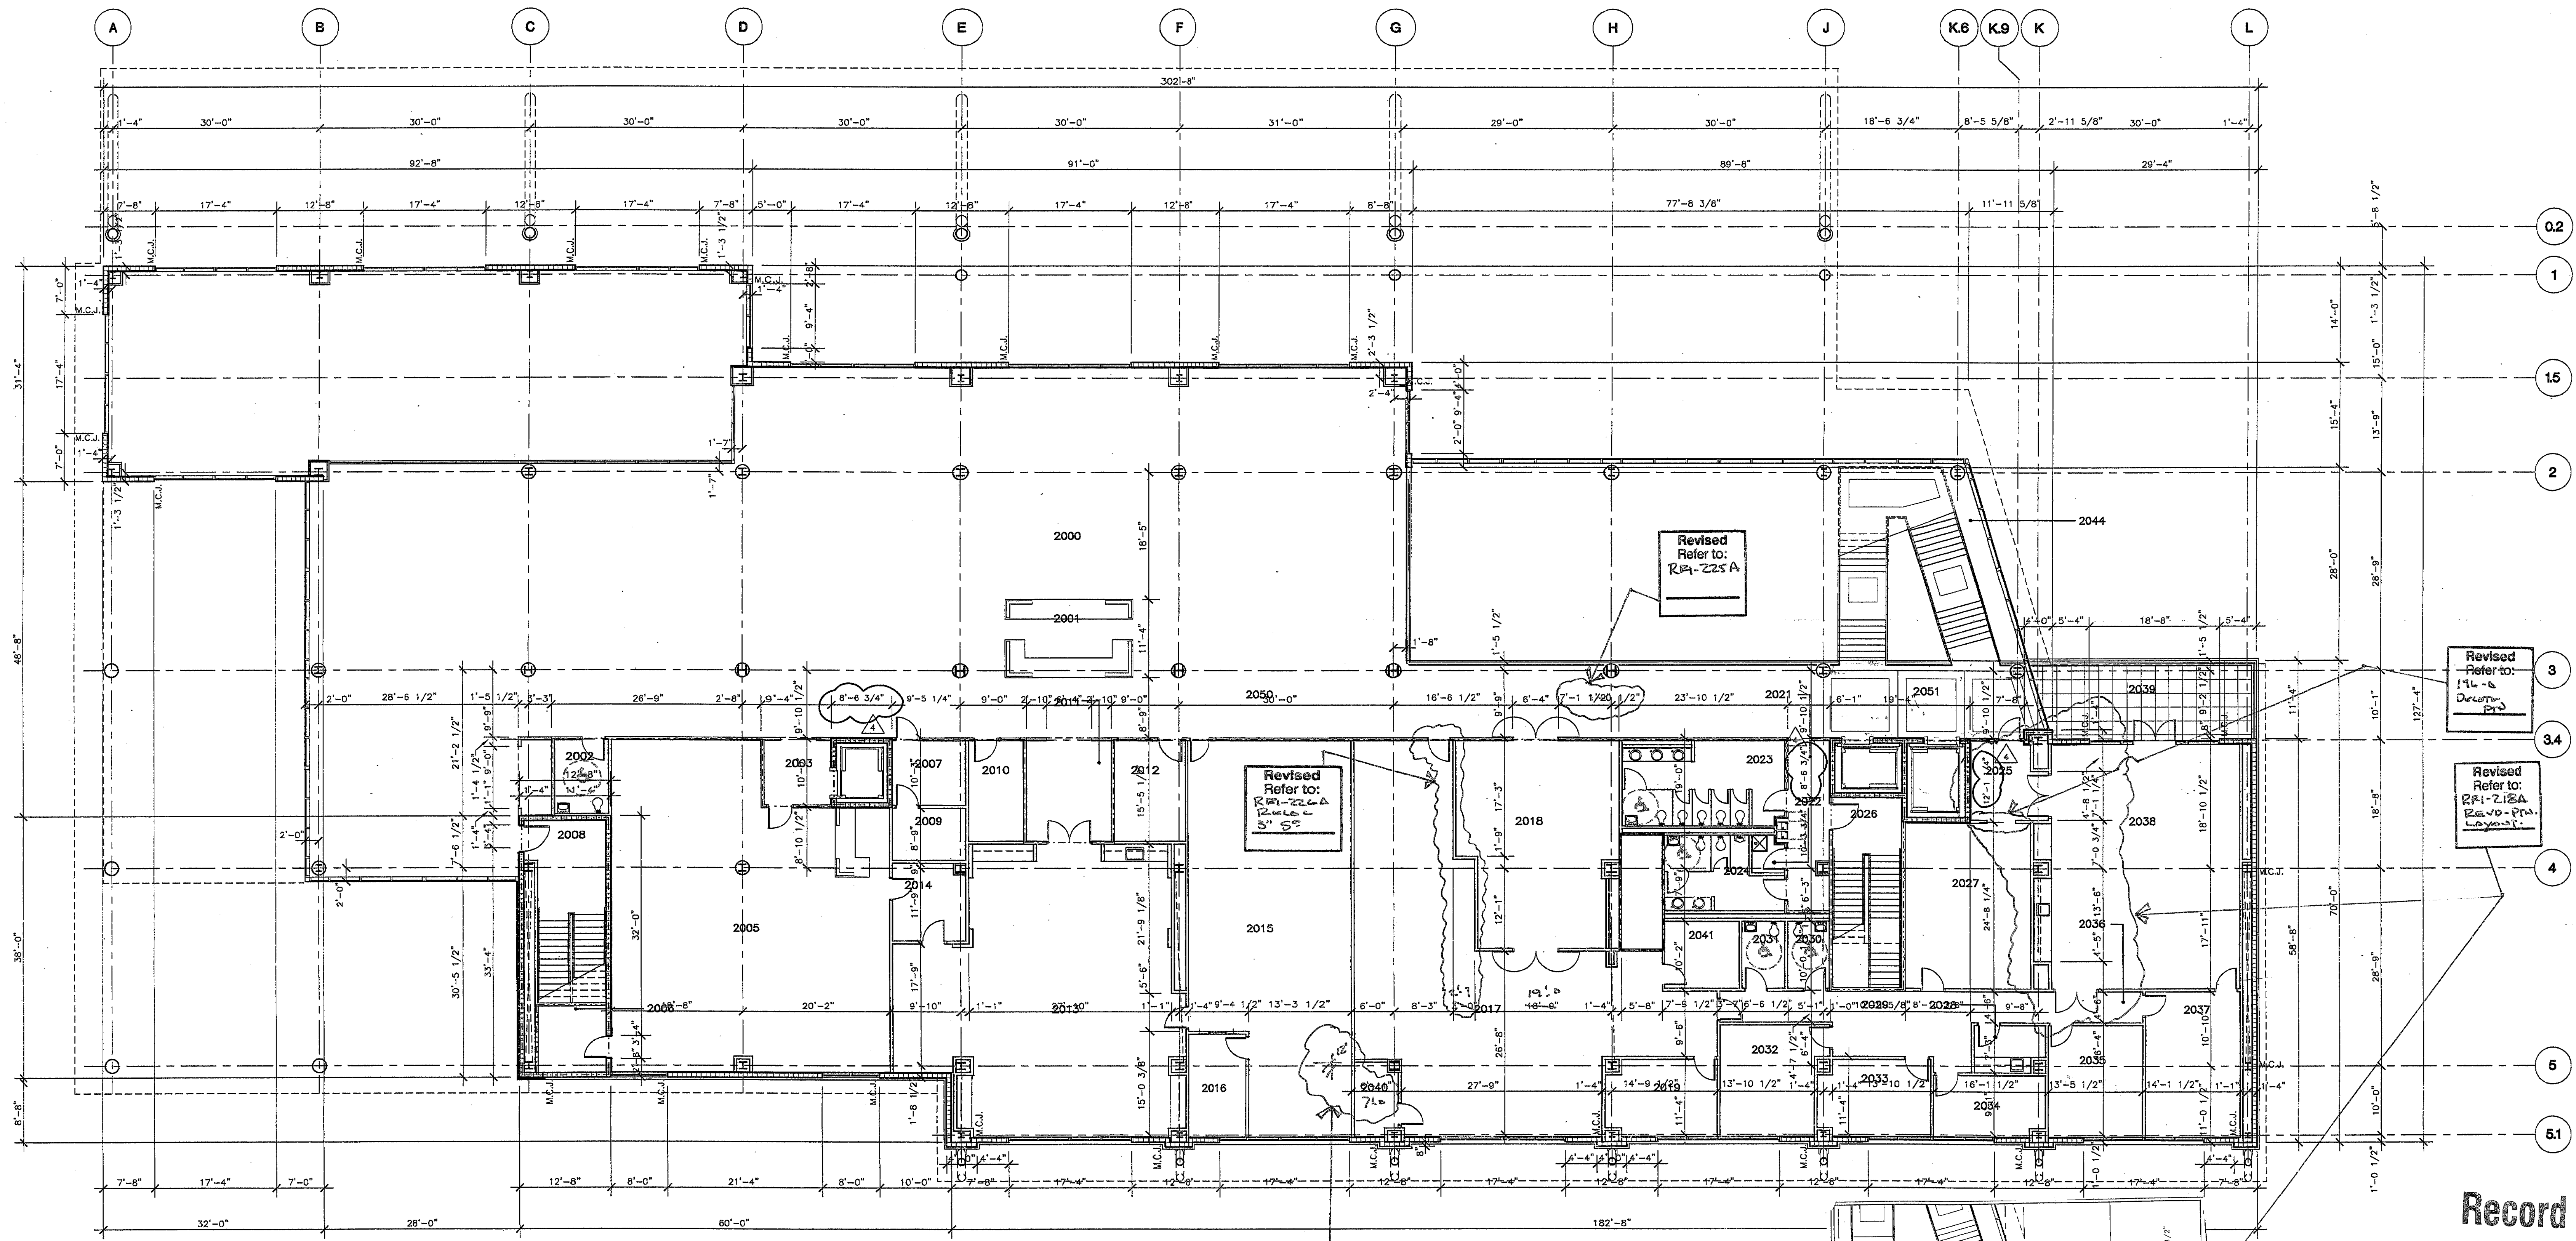


Record Set

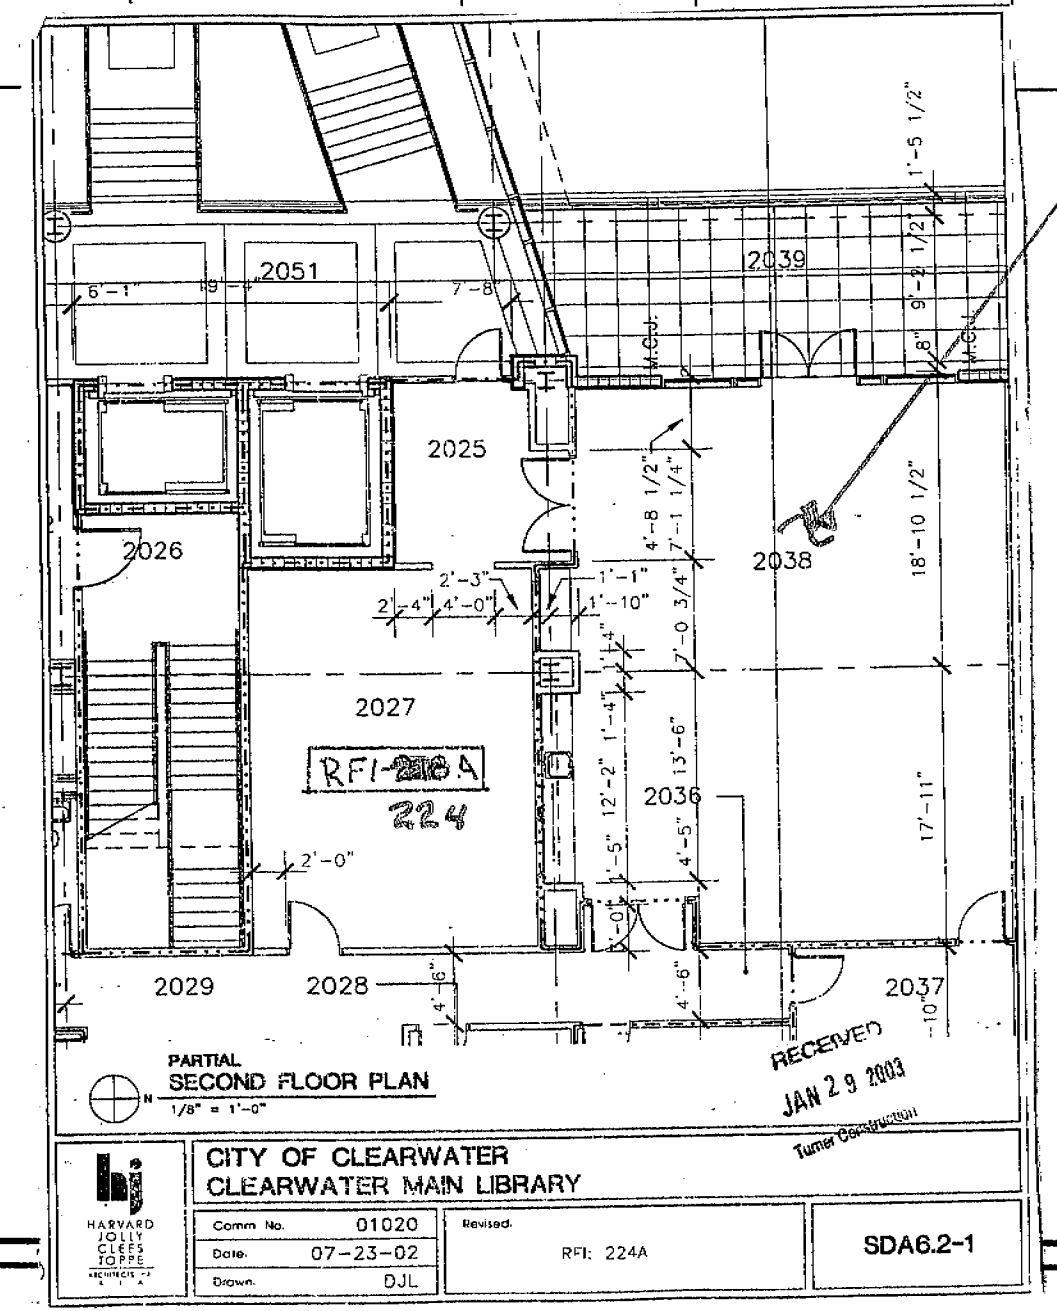

**DIMENSION
SECOND FLOOR PLAN**


3/32" = 1'-0"
0 4' 8' 24'


Turner Construction
Clearwater Library Project
PCO #011 27 Sept 02
Revision (4)

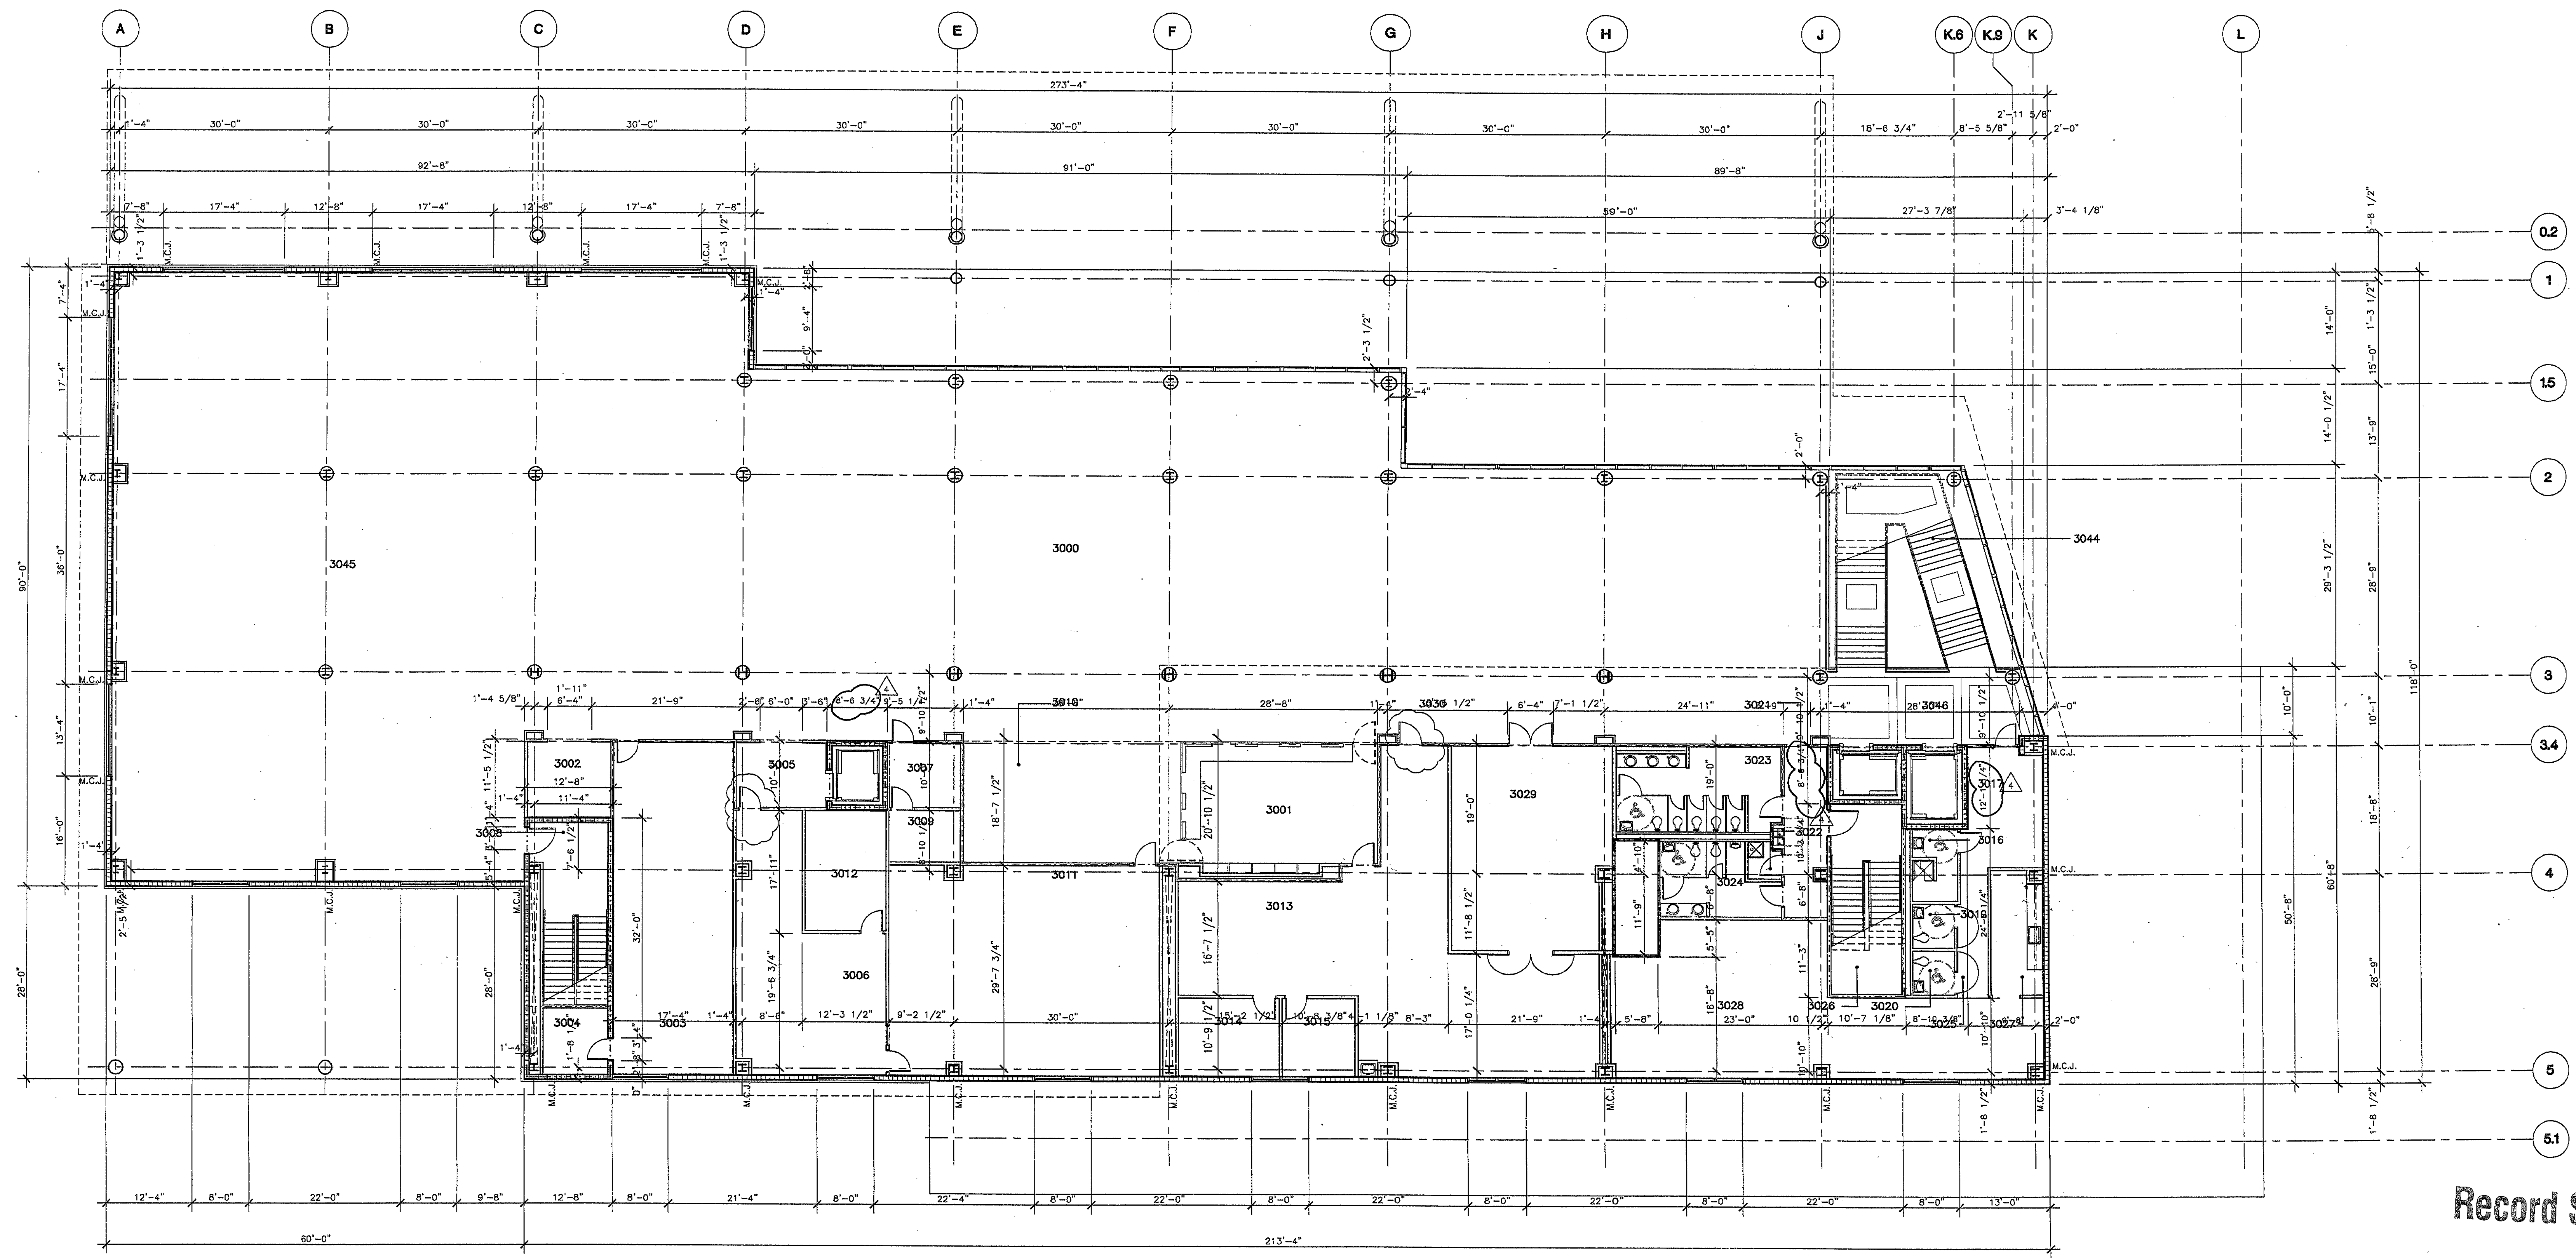

Record Set

Turner Construction
 Clearwater Library Project
 PCO #011 27 Sept 02
 Revision (4)

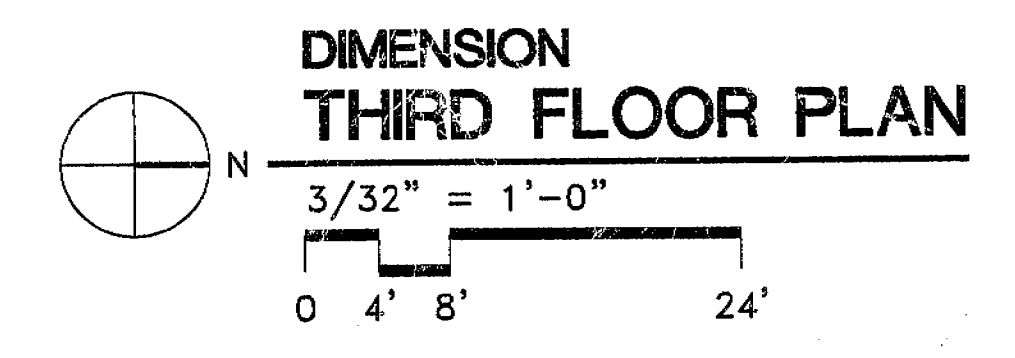

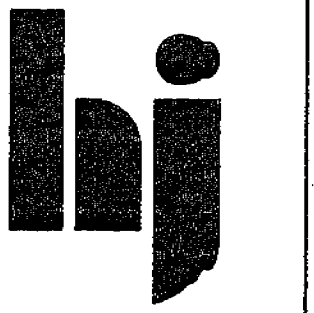

HARVARD
JOLLY
CLEES
TOPPE
ARCHITECTS, P.A.
A I A


2714 Ninth St.
St. Petersburg, FL
33704
727/894 4011
AA C00019

DESIGN ARCHITECT
ROBERT A.M. STERN ARCHITECTS
460 WEST 34th STREET, NEW YORK, NY 10001
TEL: (212) 867-1000 • FAX: (212) 867-5888

CITY OF CLEARWATER
CLEARWATER MAIN LIBRARY
100 NORTH OSCEOLA AVENUE, CLEARWATER, FL 33755
100% CONSTRUCTION DOCUMENTS

Comm. No. 01020
Date: 07-23-02
Drawn:
Revised:
▲ 09-02-02

© 2002 HJCT, P.A., AIA
A6.4

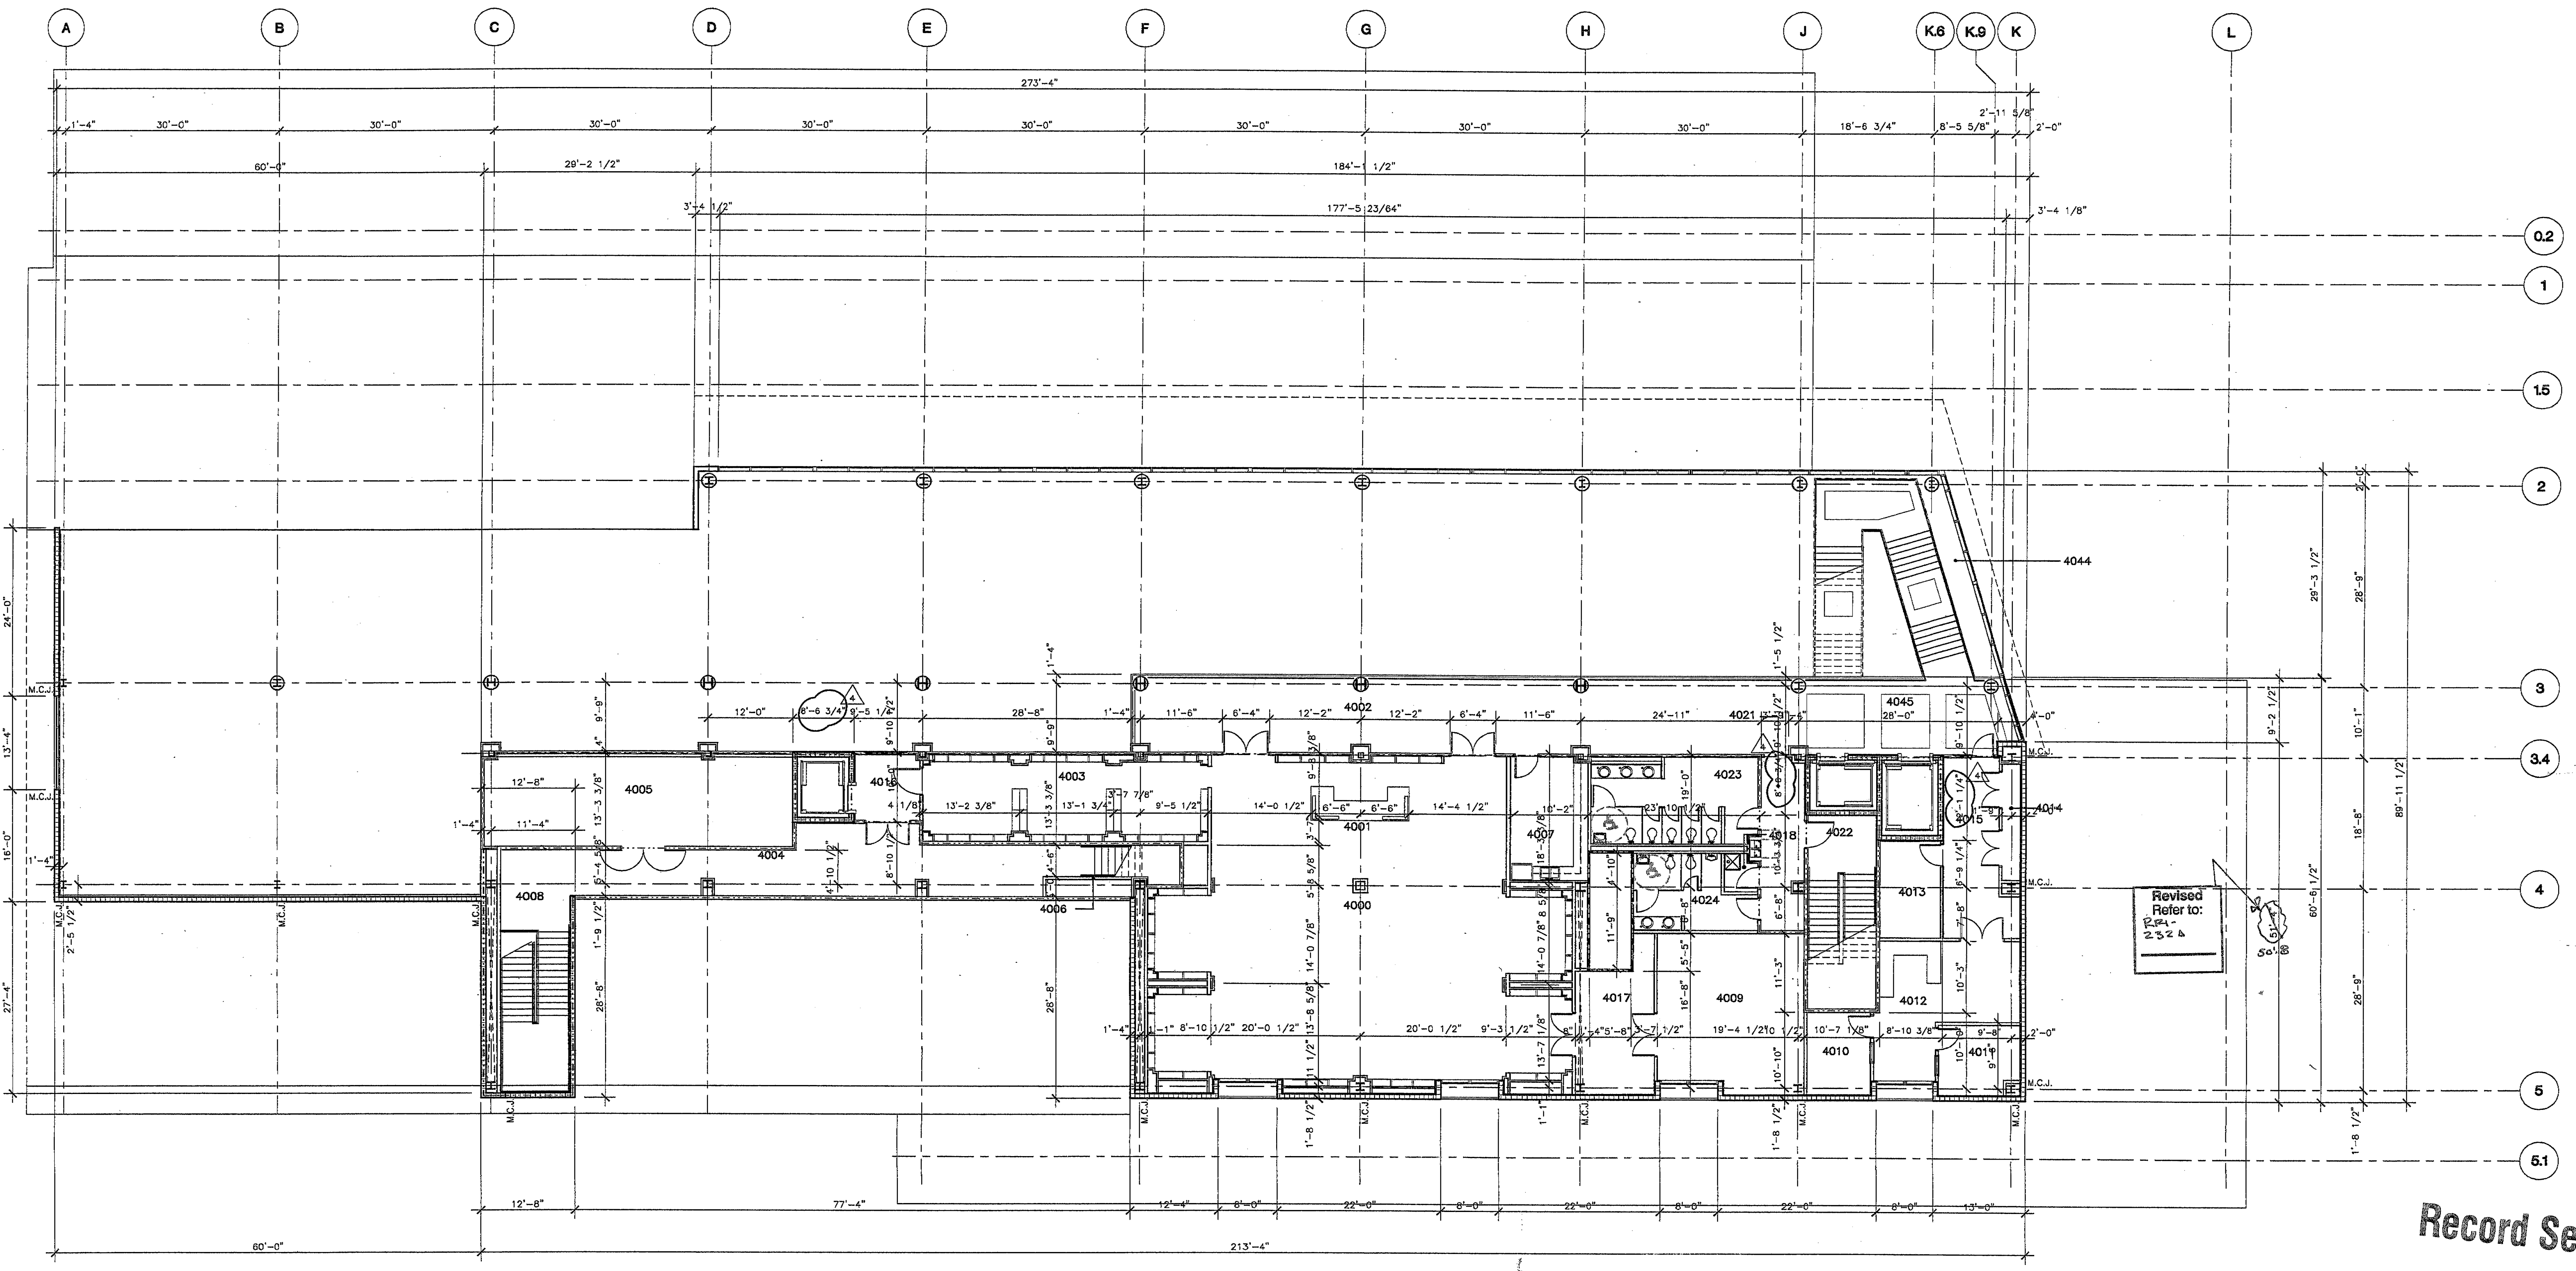

Revised
Refer to:
1. 10-11-02
2. 10-11-02
3. 10-11-02

Record Set

Turner Construction
Clearwater Library Project
PCO #011 27 Sept 02
Revision (4)

DIMENSION
FOURTH FLOOR PLAN
3/32" = 1'-0"
0 4' 8" 24'

12-18-01 4:11P

HW


hj
 HARVARD
 JOLLY
 CLEES
 TOPPE
 ARCHITECTS, P.A.
 A I A
 2714 Ninth St. N.
 St. Petersburg, FL
 33704
 727/896 4611
 AA C00019

DESIGN ARCHITECT
ROBERT A.M. STERN ARCHITECTS
 100 WEST 94th STREET, NEW YORK, NY 10021
 TEL: (212) 897-5100 • FAX: (212) 897-5950

CITY OF CLEARWATER
CLEARWATER MAIN LIBRARY
 100 NORTH OSCEOLA AVENUE, CLEARWATER, FL 33755
 100% CONSTRUCTION DOCUMENTS


Comm. No. 01020
 Date: 07-23-02
 Drawn:
 Revised:
 09-02-02

©2002 HJCT, P.A., AIA
A6.5

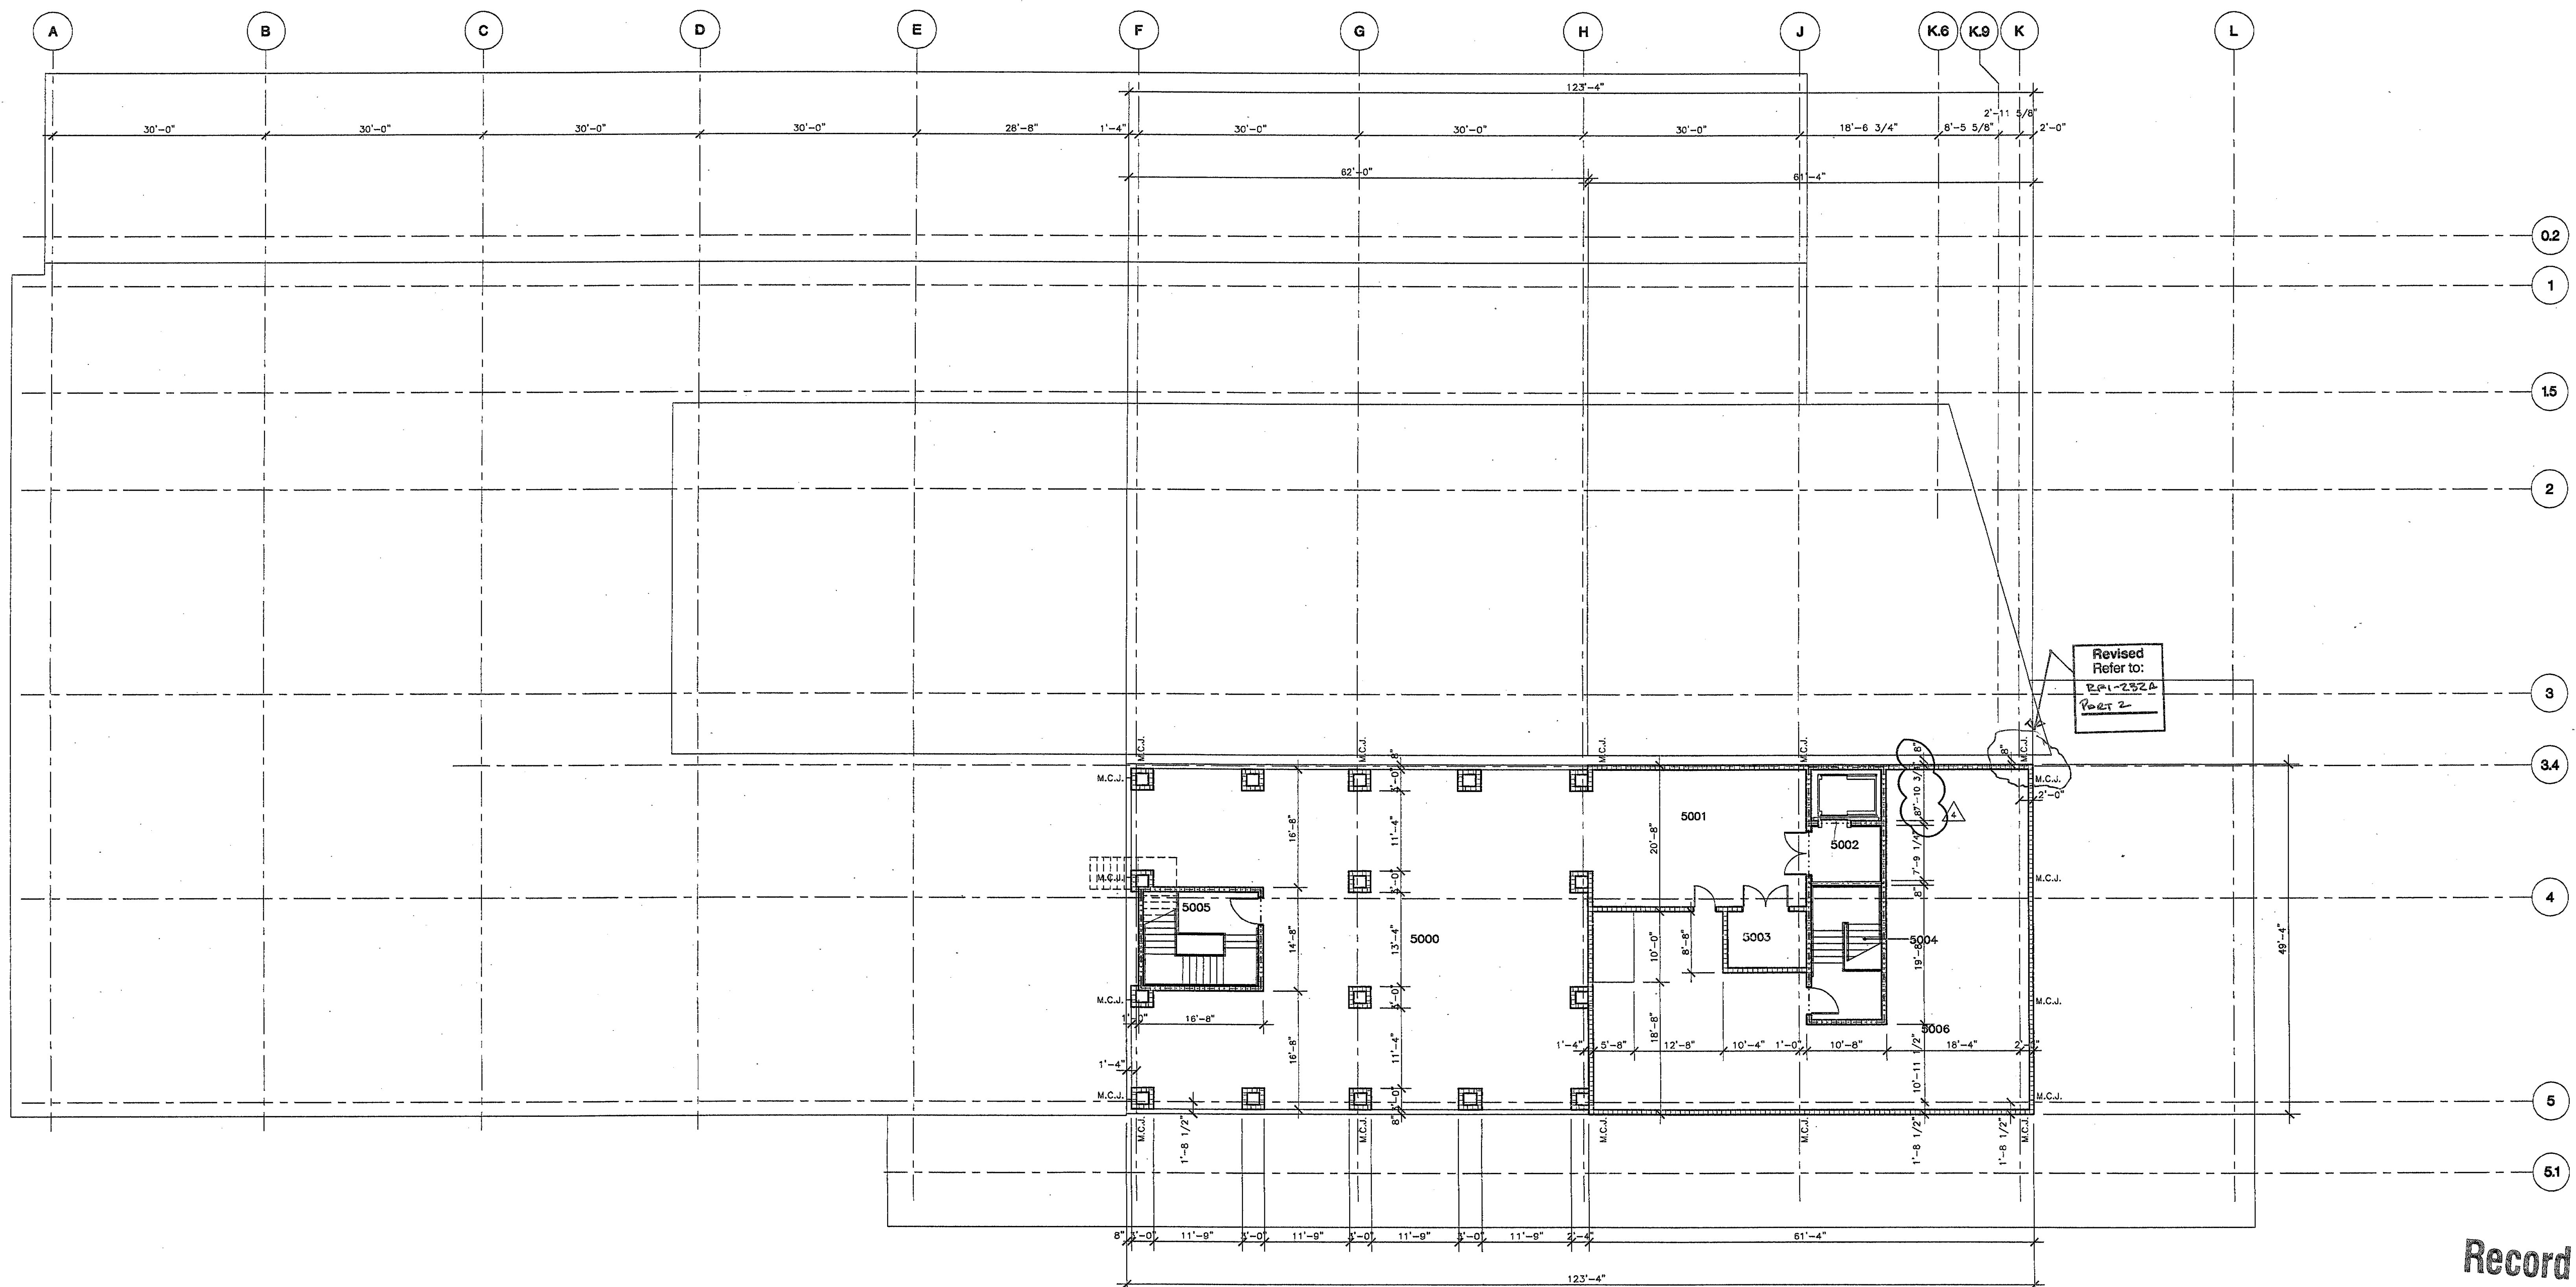

Record Set

Turner Construction
 Clearwater Library Project
 PCO #011 27 Sept 02
 Revision (4)

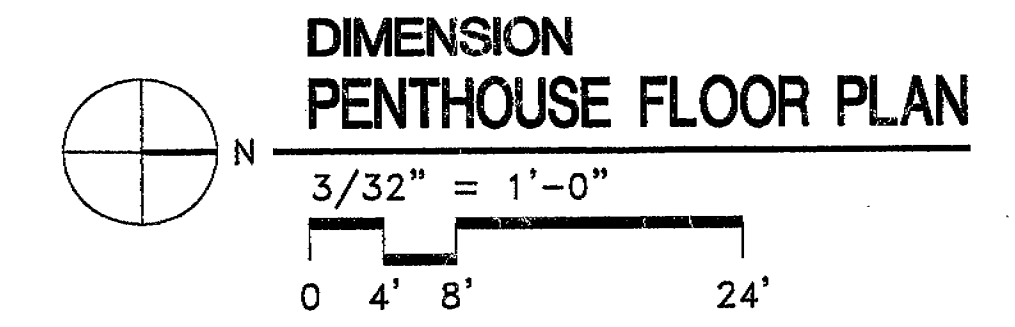

FN: 30A06-5-01020.DWG